

Toronto Community Housing Corporation

931 Yonge St., 3rd floor
 Toronto, ON, M2W 2H2
 Phone: 416-981-4173
 Fax : 416-981-4150



MEMAR CONSULTANTS INC. HAS CONDUCTED THE AS-BUILT MEASURING OF THIS BUILDING USING LASER TECHNOLOGY. THE INFORMATION OFFERED IN THIS DOCUMENT ARE BELIEVED TO BE ACCURATE. WHILE ALL THE EFFORTS ARE MADE TO CREATE THE MOST ACCURATE RESULT; IT SHOULD BE CONSIDERED AS AN ESTIMATE. PLEASE CONTACT US DIRECTLY WITH ANY QUESTION REGARDING THIS PRODUCT AT: 1-877-776-7639 OR VISIT OUR WEBSITE FOR SAMPLES.

MERCEDEH ARBAB		36276
NAME	SIGNATURE	BCIN
MEMAR CONSULTANTS		36837
FIRM NAME	SIGNATURE	BCIN

PROJECT ADDRESS:

53 Lower Jarvis
 TORONTO, ON

DRAWING TITLE:

Floor Plan

NOTES:


1996 BOMA STANDARD

MEMAR
 CONSULTANTS INC.

This Product is Prepared by
 "Memar Consultants Inc."
 T: 1-877-776-7639
 T: 416-575-4448

www.MemarConsultants.com



NORTH:

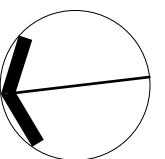

VERSION: 1.0

DATE: 22/10/2009

A2

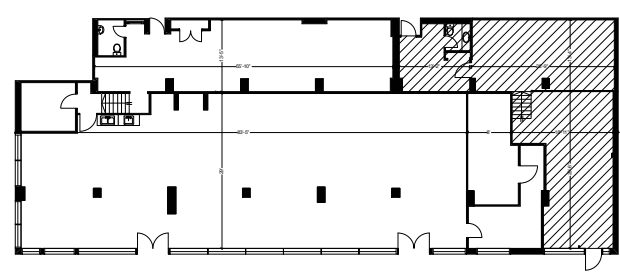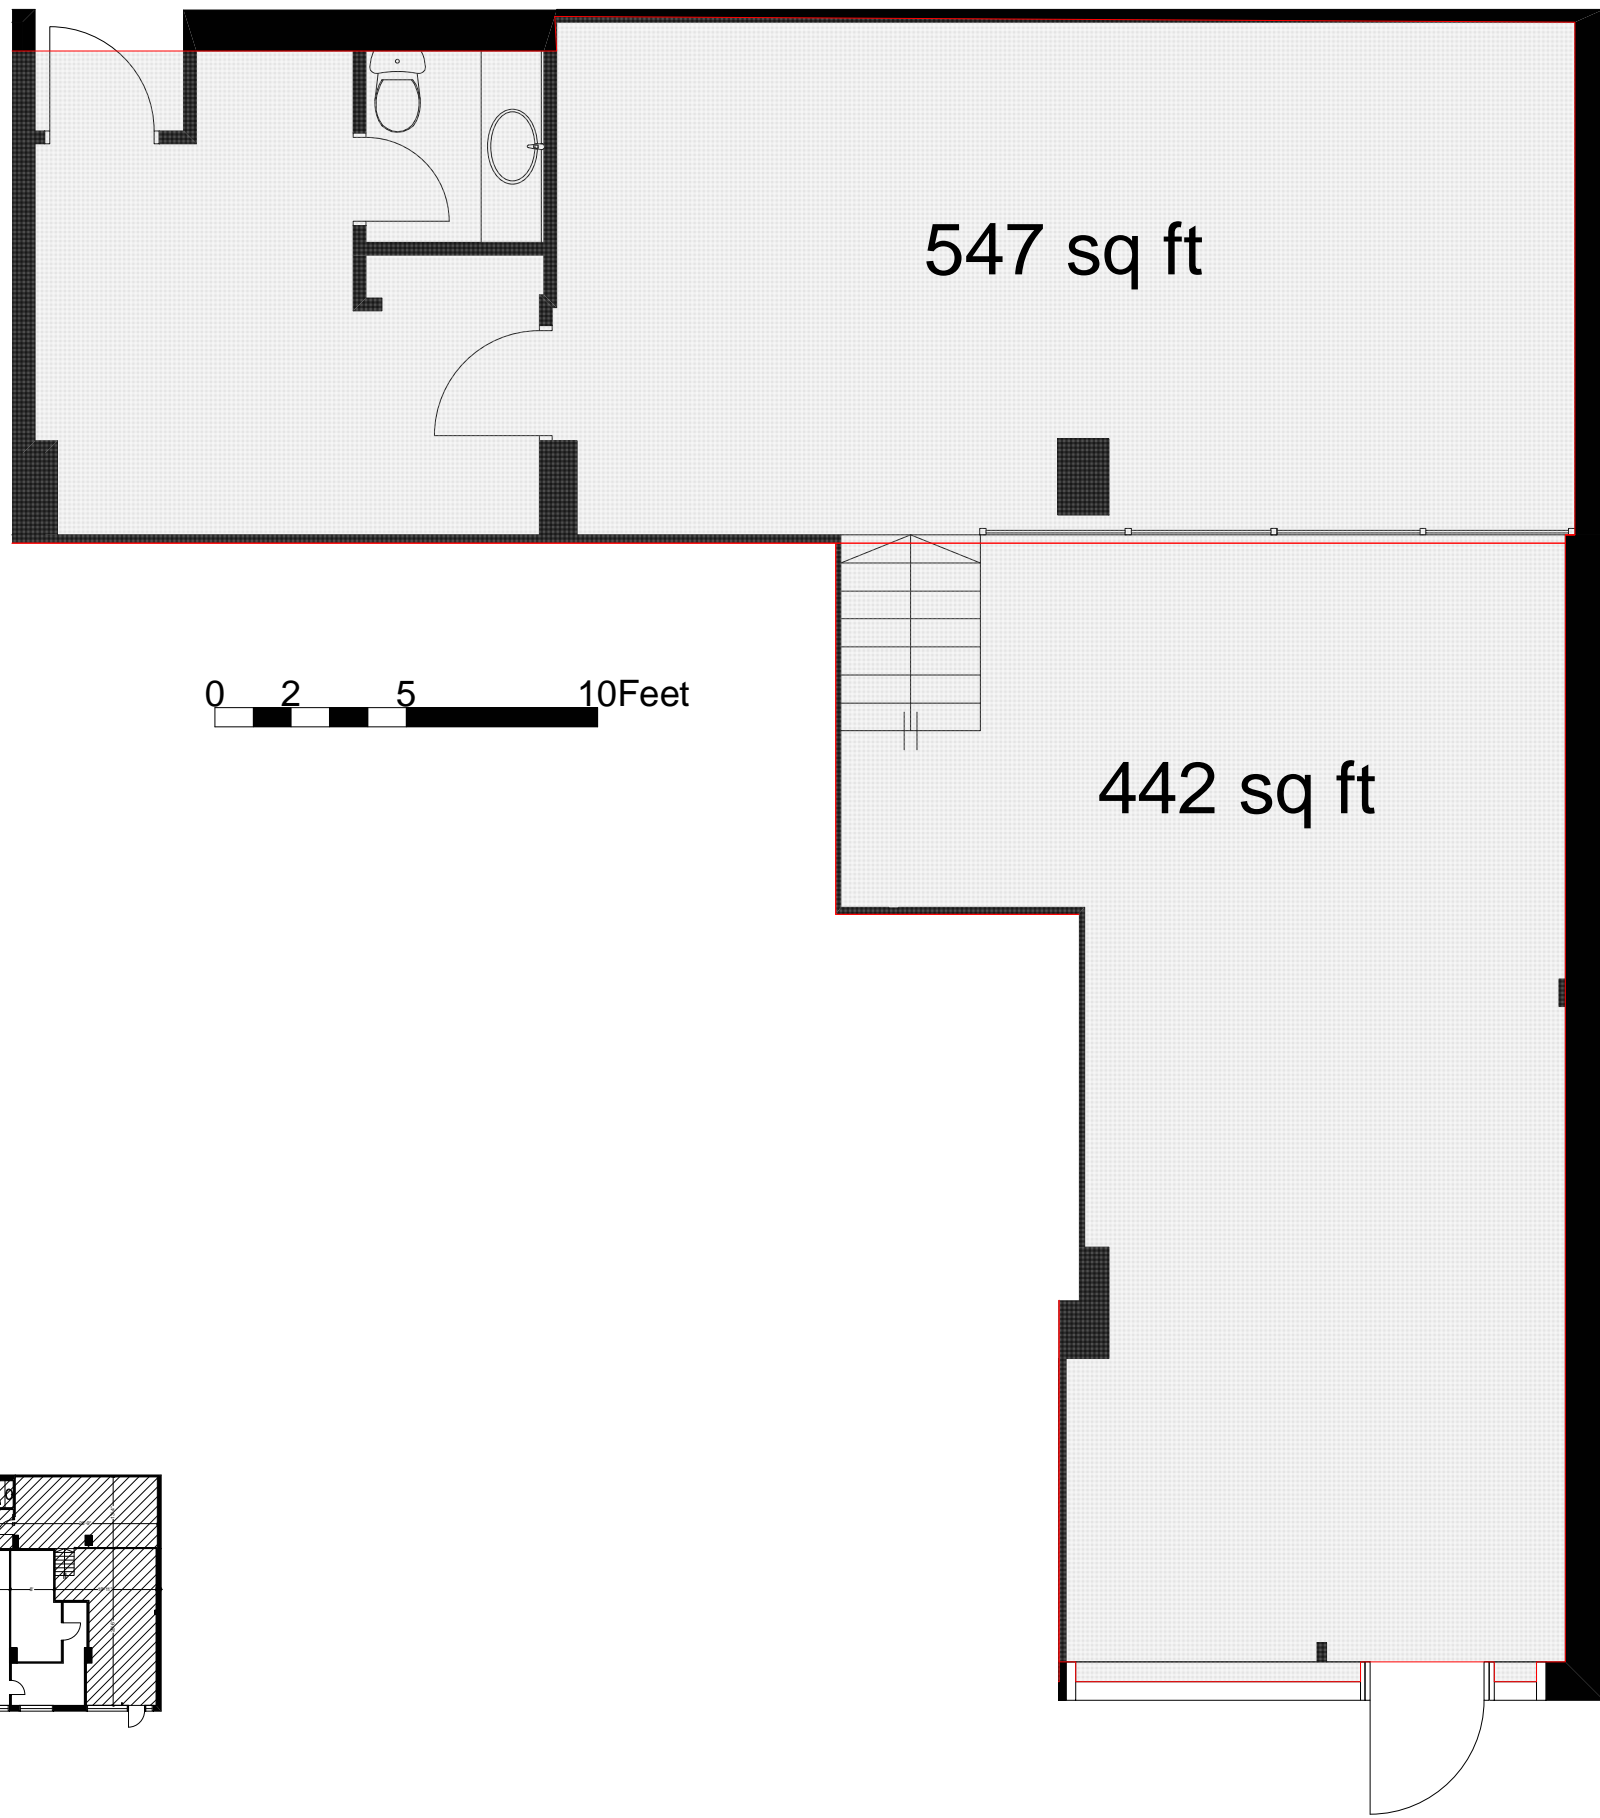

Toronto Community Housing Corporation

931 Yonge St., 3rd floor
 Toronto, ON, M2W 2H2
 Phone: 416-981-4173
 Fax : 416-981-4150



MEMAR CONSULTANTS INC. HAS CONDUCTED THE AS-BUILT MEASURING OF THIS BUILDING USING LASER TECHNOLOGY. THE INFORMATION OFFERED IN THIS DOCUMENT ARE BELIEVED TO BE ACCURATE. WHILE ALL THE EFFORTS ARE MADE TO CREATE THE MOST ACCURATE RESULT; IT SHOULD BE CONSIDERED AS AN ESTIMATE. PLEASE CONTACT US DIRECTLY WITH ANY QUESTION REGARDING THIS PRODUCT AT: 1-877-776-7639 OR VISIT OUR WEBSITE FOR SAMPLES.

MERCEDEH ARBAB	<i>M. Arbab</i>	36276
NAME	SIGNATURE	BCIN
MEMAR CONSULTANTS	<i>Haori</i>	36837
FIRM NAME	SIGNATURE	BCIN



PROJECT ADDRESS:
 53 Lower Jarvis
 TORONTO, ON

DRAWING TITLE:
 Usable Floor Area

NOTES:
 1996 BOMA STANDARD
 Total Usable Floor Area
 989 sq ft

 This Product is Prepared by "Memar Consultants Inc." T: 1-877-776-7639 T: 416-575-4448 www.MemarConsultants.com	NORTH:
---	-------------------

VERSION: 1.0 DATE: 22/10/2009	A2
--	-----------

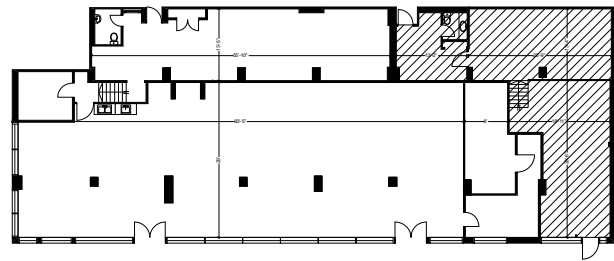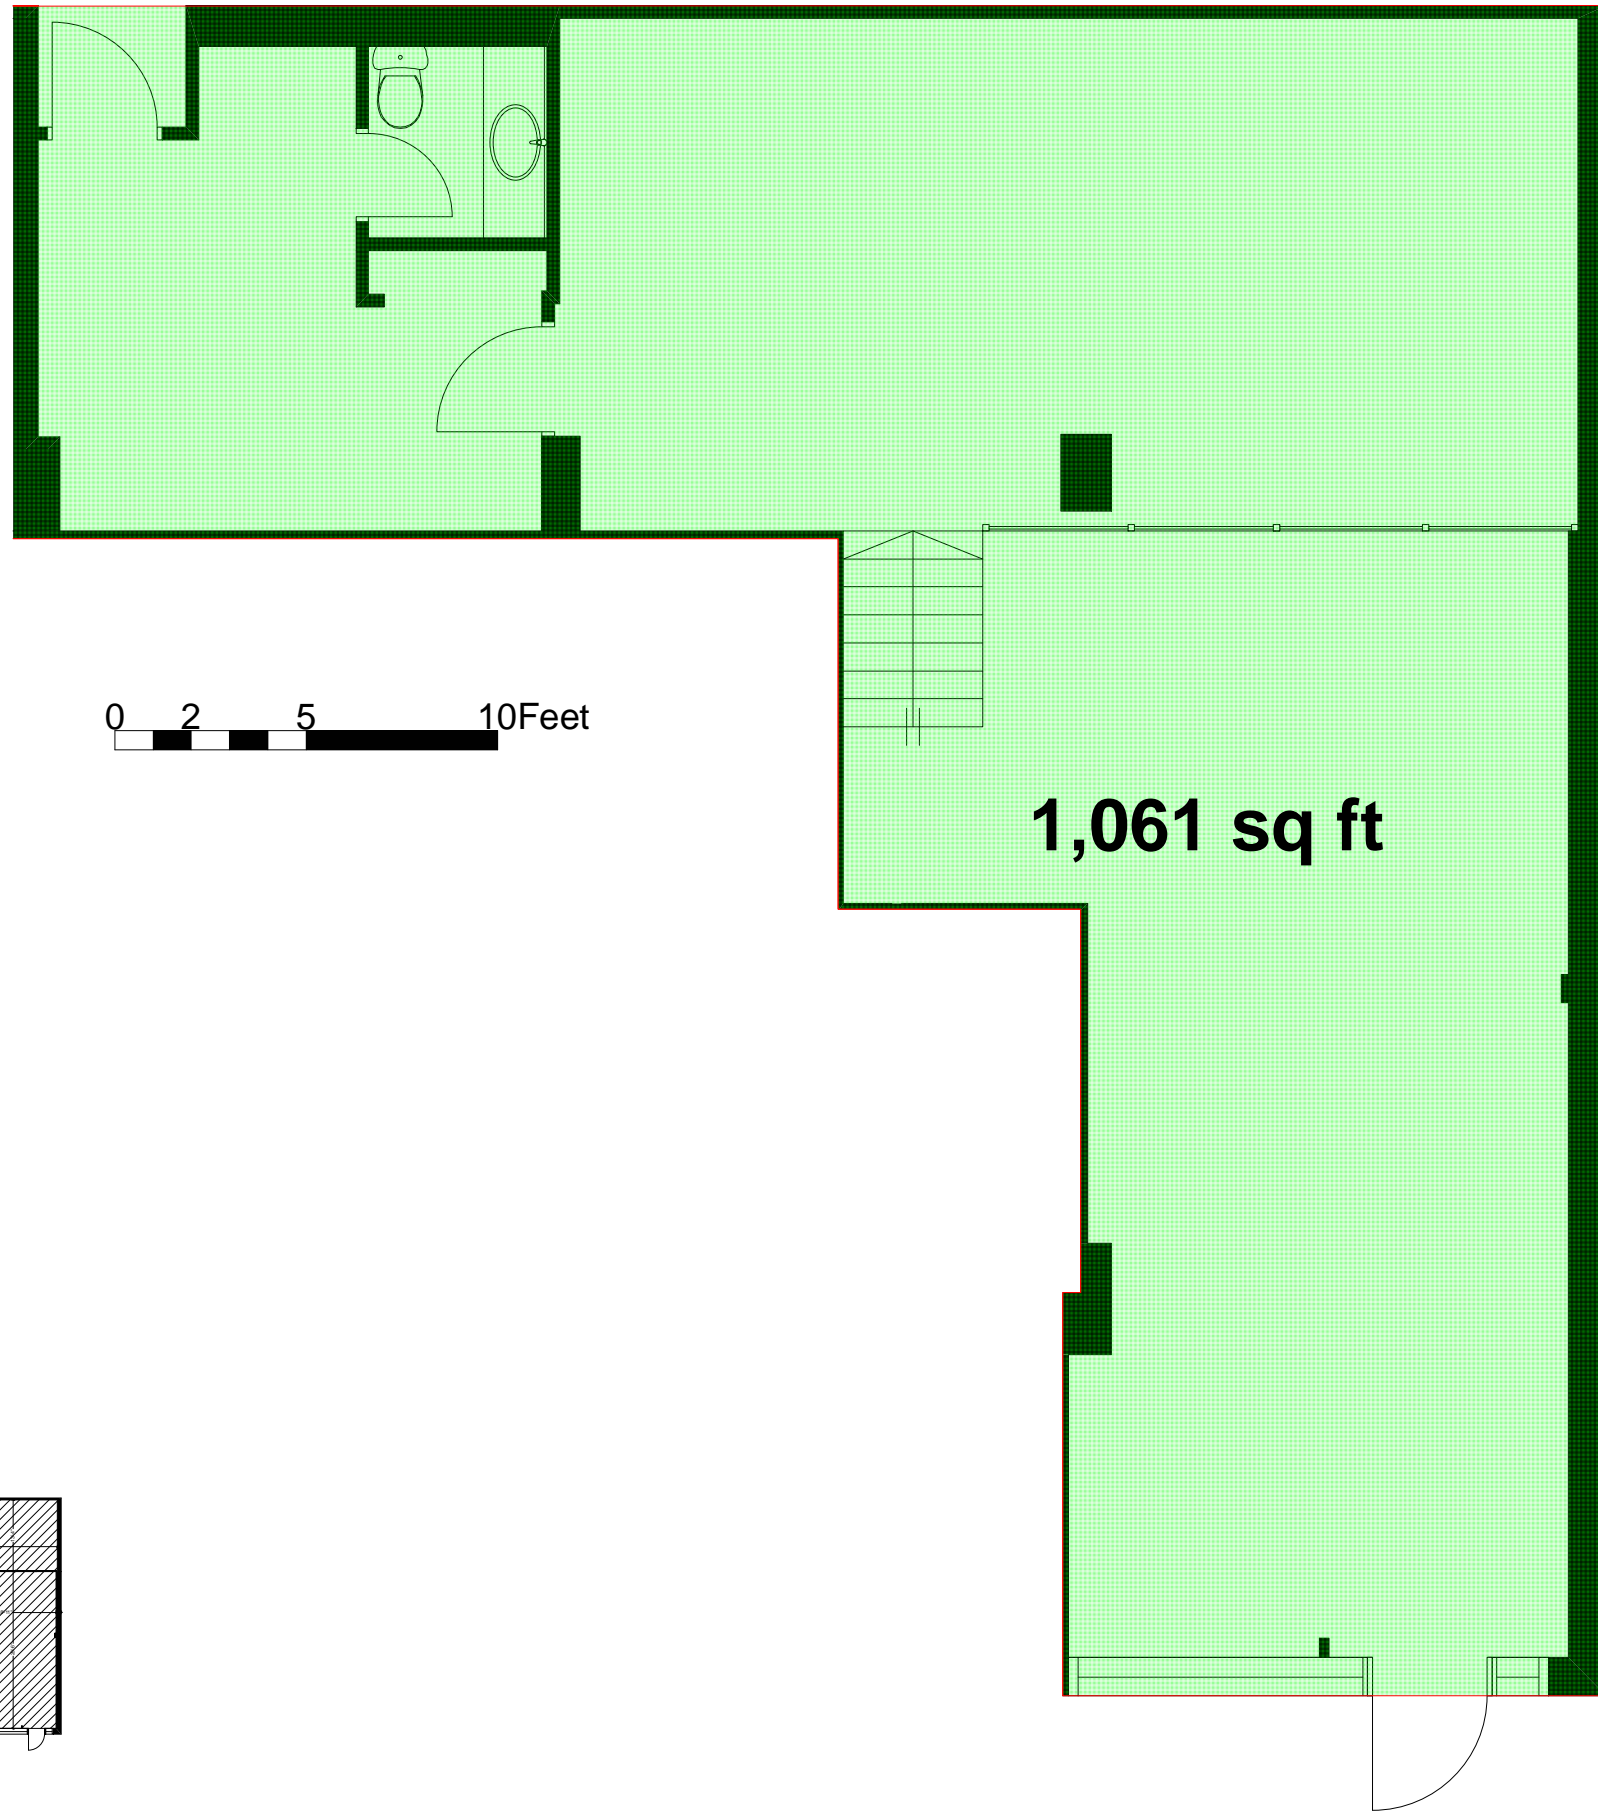

Toronto Community Housing Corporation

931 Yonge St., 3rd floor
 Toronto, ON, M2W 2H2
 Phone: 416-981-4173
 Fax : 416-981-4150



MEMAR CONSULTANTS INC. HAS CONDUCTED THE AS-BUILT MEASURING OF THIS BUILDING USING LASER TECHNOLOGY. THE INFORMATION AFFORDED IN THIS DOCUMENT ARE BELIEVED TO BE ACCURATE. WHILE ALL THE EFFORTS ARE MADE TO CREATE THE MOST ACCURATE RESULT; IT SHOULD BE CONSIDERED AS AN ESTIMATE. PLEASE CONTACT US DIRECTLY WITH ANY QUESTION REGARDING THIS PRODUCT AT: 1-877-776-7639 OR VISIT OUR WEBSITE FOR SAMPLES.

MERCEDEH ARBAB		36276
NAME	SIGNATURE	BCIN
MEMAR CONSULTANTS		36837
FIRM NAME	SIGNATURE	BCIN

PROJECT ADDRESS:

53 Lower Jarvis
 TORONTO, ON

DRAWING TITLE:

Gross Floor Area

NOTES:


1996 BOMA STANDARD

Gross Floor Area
 1,061 sq ft



This Product is Prepared by
 "Memar Consultants Inc."
 T: 1-877-776-7639
 T: 416-575-4448
 www.MemarConsultants.com


NORTH:

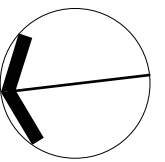

VERSION: 1.0

DATE: 22/10/2009

A2

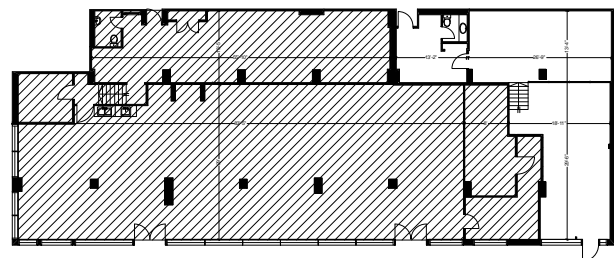

Toronto Community Housing Corporation

931 Yonge St., 3rd floor
 Toronto, ON, M2W 2H2
 Phone: 416-981-4173
 Fax : 416-981-4150



MEMAR CONSULTANTS INC. HAS CONDUCTED THE AS-BUILT MEASURING OF THIS BUILDING USING LASER TECHNOLOGY. THE INFORMATION OFFERED IN THIS DOCUMENT ARE BELIEVED TO BE ACCURATE. WHILE ALL THE EFFORTS ARE MADE TO CREATE THE MOST ACCURATE RESULT; IT SHOULD BE CONSIDERED AS AN ESTIMATE. PLEASE CONTACT US DIRECTLY WITH ANY QUESTION REGARDING THIS PRODUCT AT: 1-877-776-7639 OR VISIT OUR WEBSITE FOR SAMPLES.

MERCEDEH ARBAB		36276
NAME	SIGNATURE	BCIN
MEMAR CONSULTANTS		36837
FIRM NAME	SIGNATURE	BCIN

PROJECT ADDRESS:

53 Lower Jarvis
 TORONTO, ON

DRAWING TITLE:

Floor Plan (1)


NOTES:

1996 BOMA STANDARD



This Product is Prepared by
 "Memar Consultants Inc."
 T: 1-877-776-7639
 T: 416-575-4448
 www.MemarConsultants.com



NORTH:

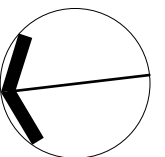

VERSION: 1.0

DATE: 22/10/2009

A2

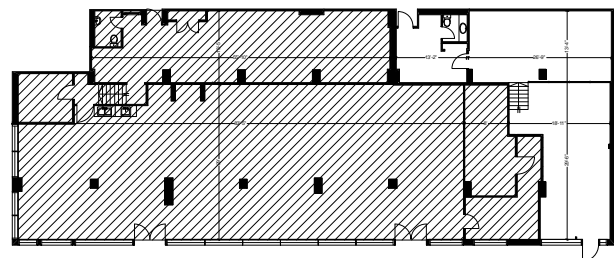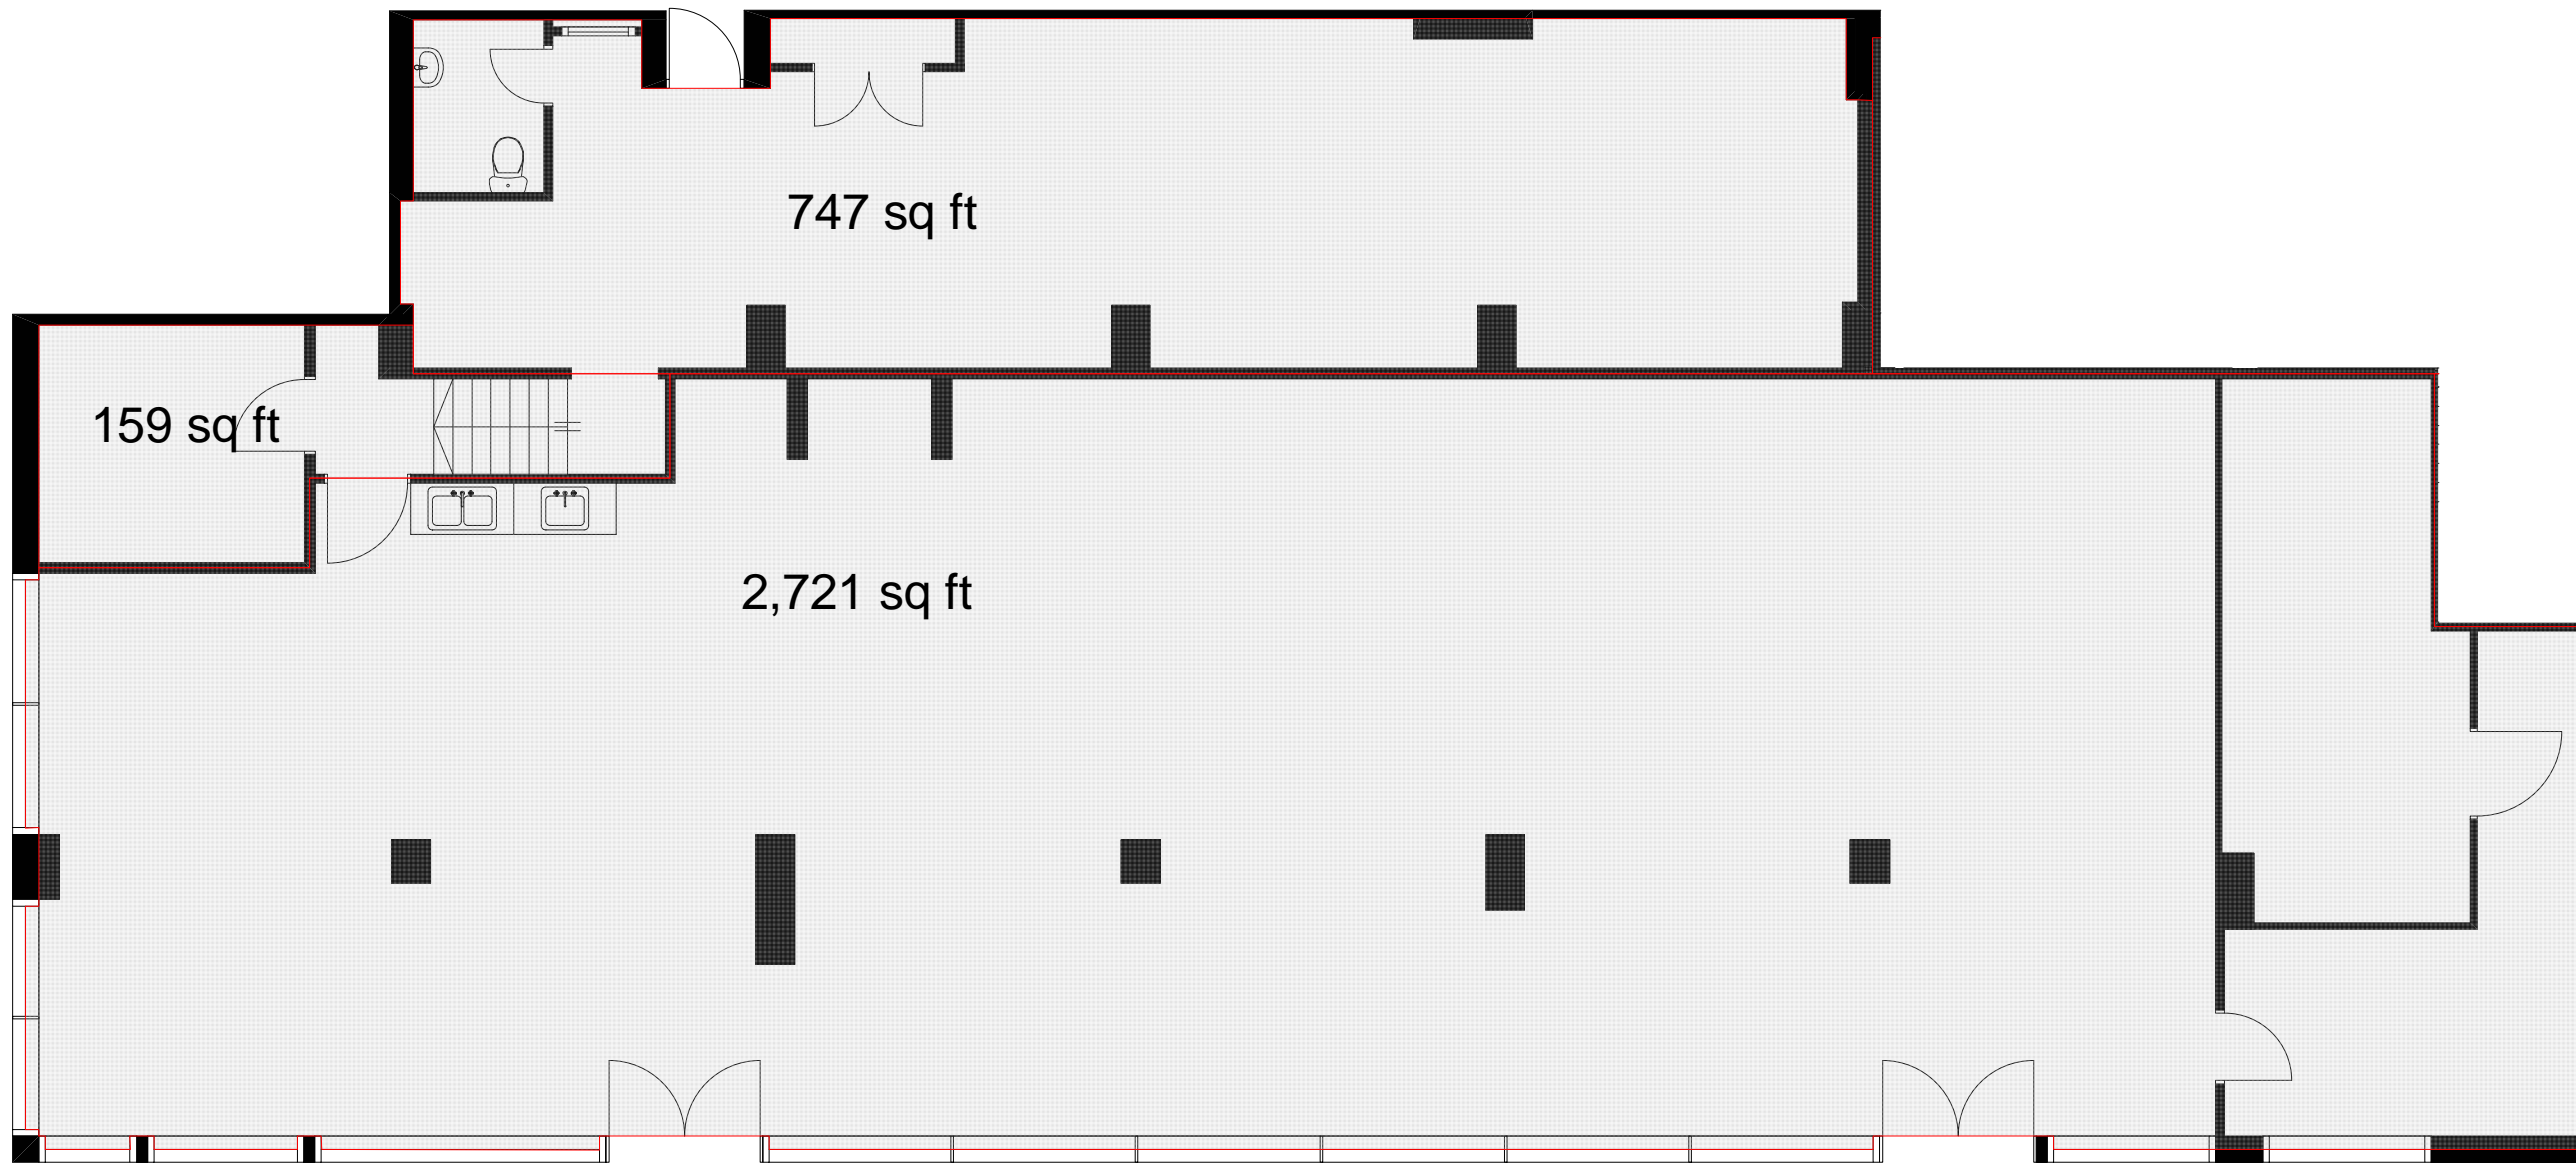

Toronto Community Housing Corporation

931 Yonge St., 3rd floor
 Toronto, ON, M2W 2H2
 Phone: 416-981-4173
 Fax : 416-981-4150



MEMAR CONSULTANTS INC. HAS CONDUCTED THE AS-BUILT MEASURING OF THIS BUILDING USING LASER TECHNOLOGY. THE INFORMATION AFFORDED IN THIS DOCUMENT ARE BELIEVED TO BE ACCURATE WHILE ALL THE EFFERTS ARE MADE TO CREATE THE MOST ACCURATE RESULT; IT SHOULD BE CONSIDERED AS AN ESTIMATE. PLEASE CONTACT US DIRECTLY WITH ANY QUESTION REGARDING THIS PRODUCT AT: 1-877-776-7639 OR VISIT OUR WEBSITE FOR SAMPLES.

MERCEDEH ARBAB		36276
NAME	SIGNATURE	BCIN
MEMAR CONSULTANTS		36837
FIRM NAME	SIGNATURE	BCIN

PROJECT ADDRESS:

53 Lower Jarvis
 TORONTO, ON

DRAWING TITLE:

Usable Floor Area (1)


NOTES:

1996 BOMA STANDARD
 Total Usable Floor Area
 3,627 sq ft



This Product is Prepared by
 "Memar Consultants Inc."
 T: 1-877-776-7639
 T: 416-575-4448
 www.MemarConsultants.com



NORTH:

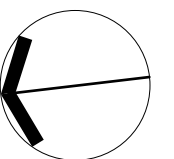

VERSION: 1.0

DATE: 22/10/2009

A2

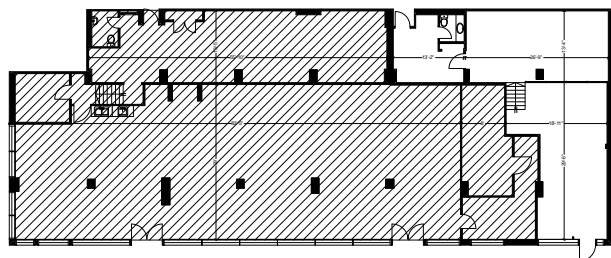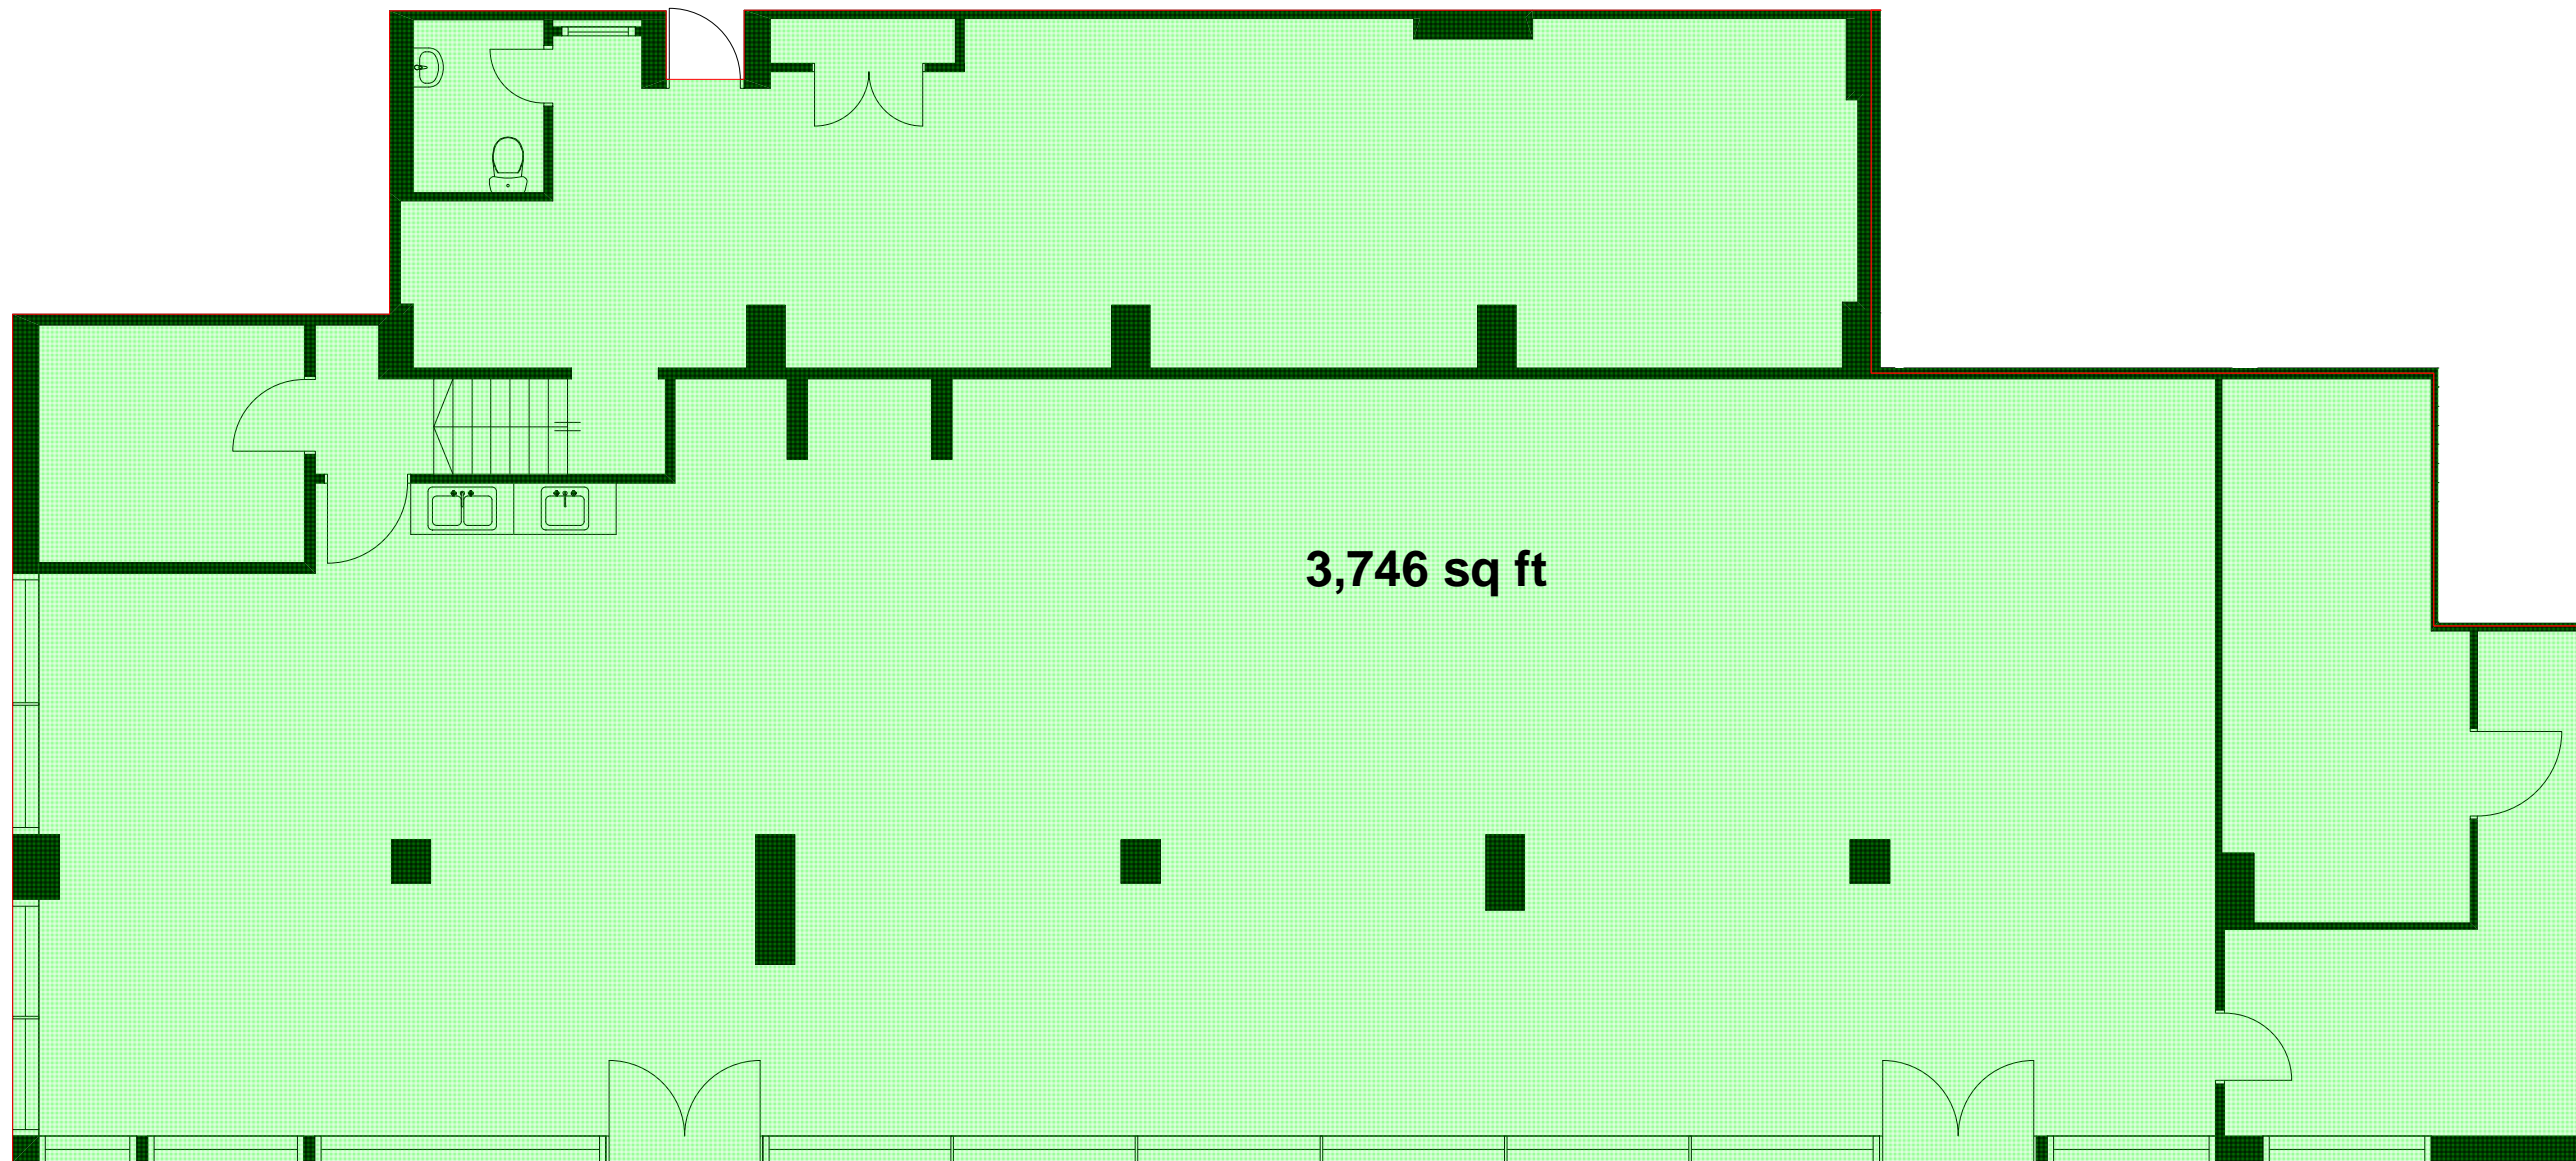

Toronto Community Housing Corporation

931 Yonge St., 3rd floor
 Toronto, ON, M2W 2H2
 Phone: 416-981-4173
 Fax : 416-981-4150



MEMAR CONSULTANTS INC. HAS CONDUCTED THE AS-BUILT MEASURING OF THIS BUILDING USING LASER TECHNOLOGY. THE INFORMATION AFFORDED IN THIS DOCUMENT ARE BELIEVED TO BE ACCURATE WHILE ALL THE EFFERTS ARE MADE TO CREATE THE MOST ACCURATE RESULT; IT SHOULD BE CONSIDERED AS AN ESTIMATE. PLEASE CONTACT US DIRECTLY WITH ANY QUESTION REGARDING THIS PRODUCT AT: 1-877-776-7639 OR VISIT OUR WEBSITE FOR SAMPLES.

MERCEDEH ARBAB		36276
NAME	SIGNATURE	BCIN
MEMAR CONSULTANTS		36837
FIRM NAME	SIGNATURE	BCIN

PROJECT ADDRESS:

53 Lower Jarvis
 TORONTO, ON

DRAWING TITLE:

Gross Floor Area (1)

NOTES:


1996 BOMA STANDARD

Gross Floor Area
 3,746 sq ft



This Product is Prepared by
 "Memar Consultants Inc."
 T: 1-877-776-7639
 T: 416-575-4448
 www.MemarConsultants.com


NORTH:

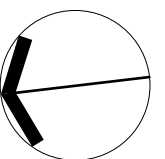

VERSION: 1.0

DATE: 22/10/2009

A2

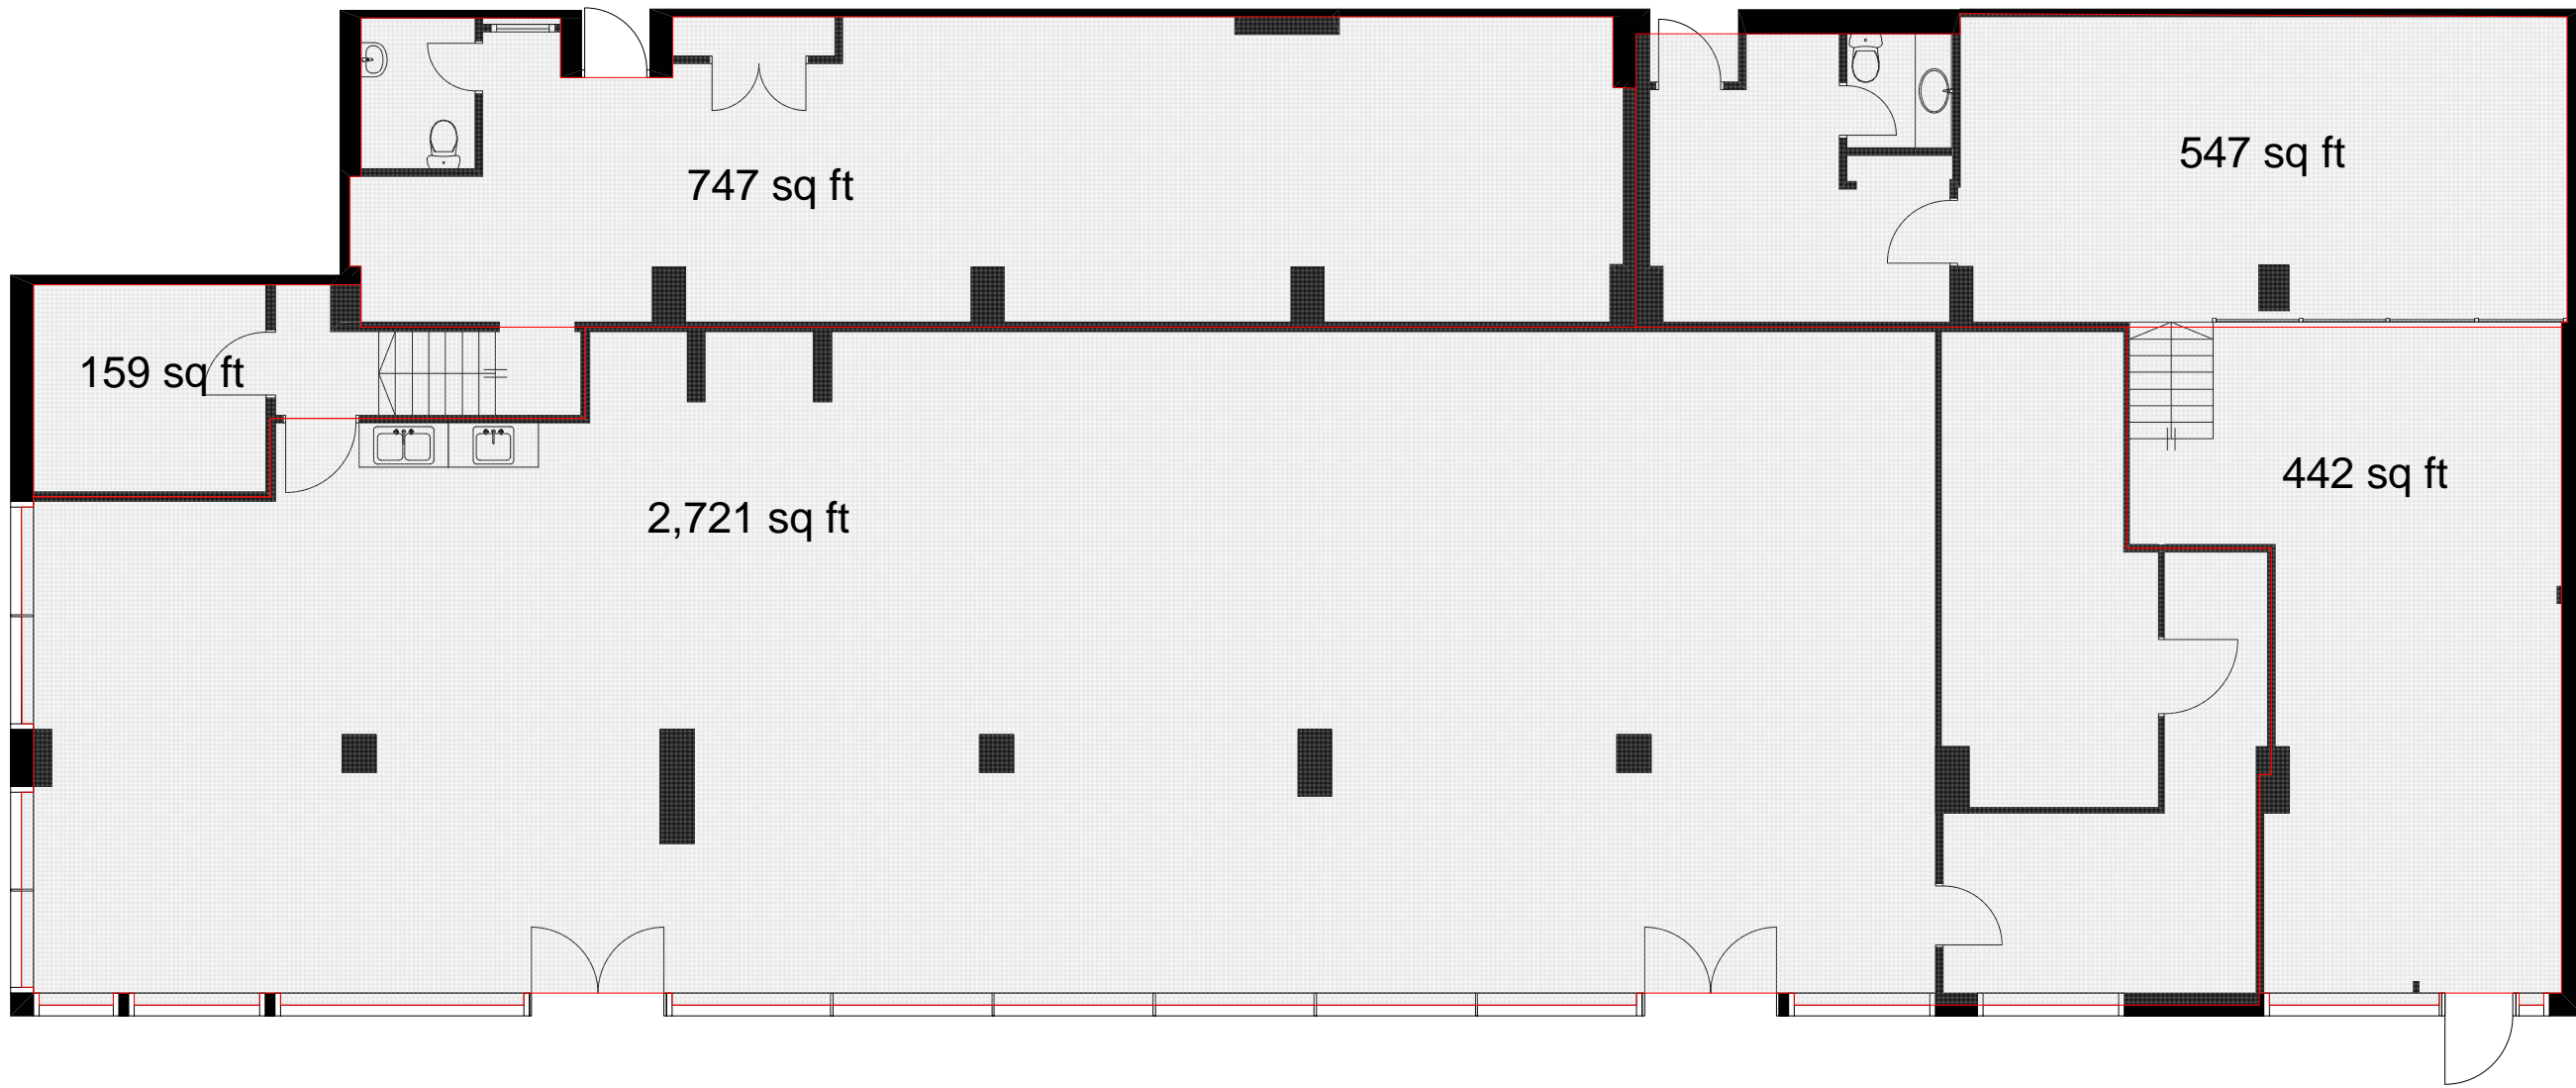

Toronto Community Housing Corporation

931 Yonge St., 3rd floor
 Toronto, ON, M2W 2H2
 Phone: 416-981-4173
 Fax : 416-981-4150



MEMAR CONSULTANTS INC. HAS CONDUCTED THE AS-BUILT MEASURING OF THIS BUILDING USING LASER TECHNOLOGY. THE INFORMATION AFFORDED IN THIS DOCUMENT ARE BELIEVED TO BE ACCURATE. WHILE ALL THE EFFORTS ARE MADE TO CREATE THE MOST ACCURATE RESULT; IT SHOULD BE CONSIDERED AS AN ESTIMATE. PLEASE CONTACT US DIRECTLY WITH ANY QUESTION REGARDING THIS PRODUCT AT: 1-877-776-7639 OR VISIT OUR WEBSITE FOR SAMPLES.

MERCEDEH ARBAB	<i>M. Arbab</i>	36276
NAME	SIGNATURE	BCIN
MEMAR CONSULTANTS	<i>Memar</i>	36837
FIRM NAME	SIGNATURE	BCIN


PROJECT ADDRESS:
 53 Lower Jarvis
 TORONTO, ON

DRAWING TITLE:
 Usable Floor Area


NOTES:
 1996 BOMA STANDARD
 Total Usable Floor Area
 4597.7 sq ft



MEMAR
 CONSULTANTS INC.
 This Product is Prepared by
 "Memar Consultants Inc."
 T: 1-877-776-7639
 T: 416-575-4448
 www.MemarConsultants.com

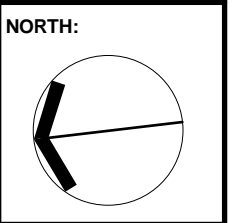

VERSION: 1.0	A2
DATE: 22/10/2009	

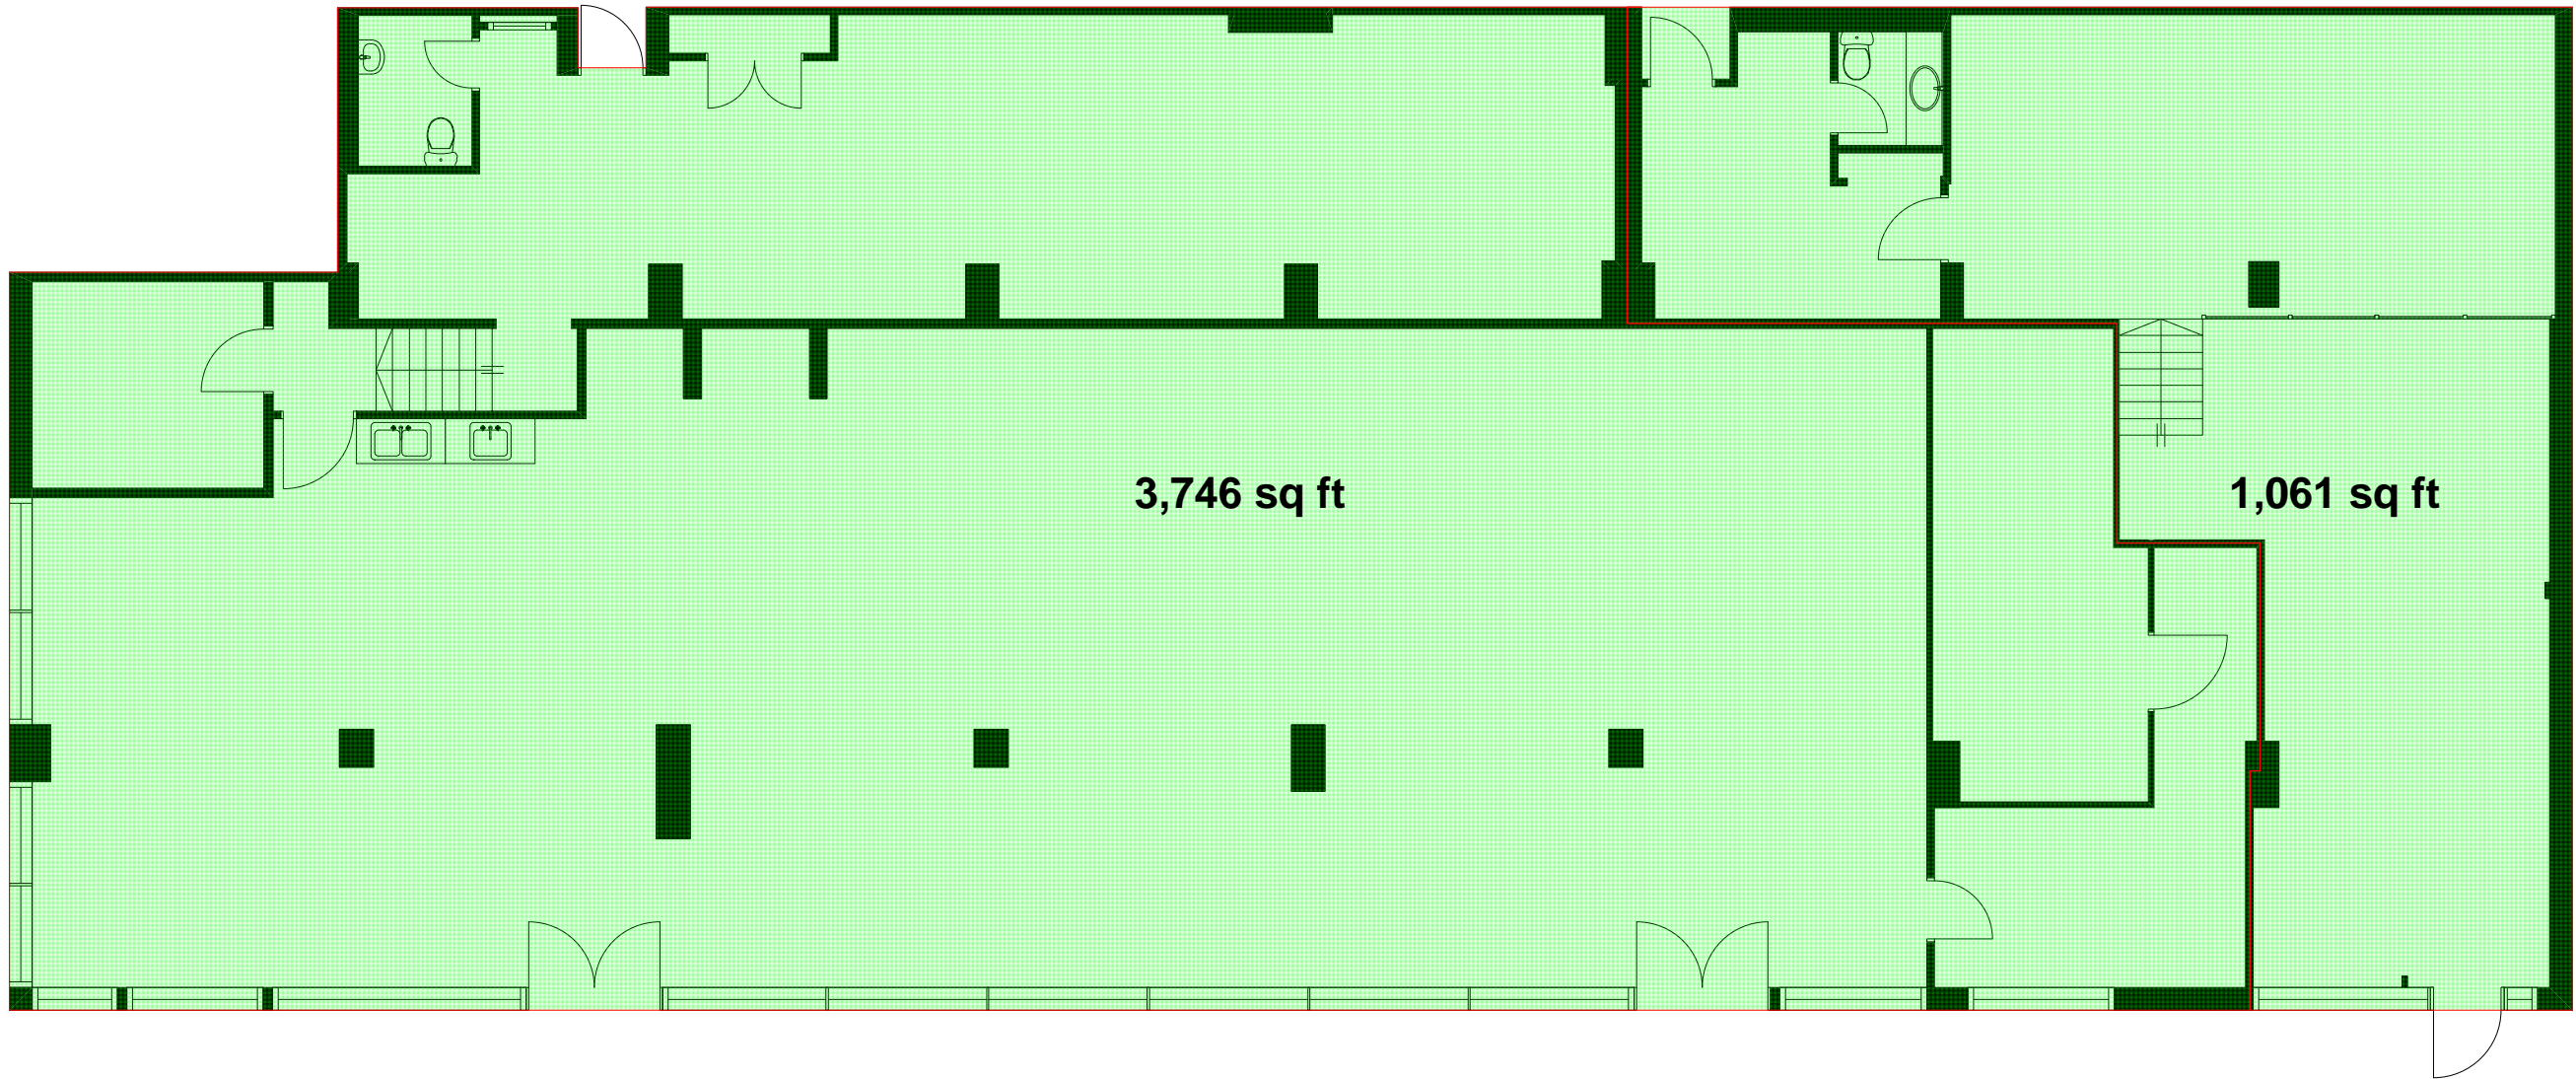

Toronto Community Housing Corporation

931 Yonge St., 3rd floor
 Toronto, ON, M2W 2H2
 Phone: 416-981-4173
 Fax : 416-981-4150



MEMAR CONSULTANTS INC. HAS CONDUCTED THE AS-BUILT MEASURING OF THIS BUILDING USING LASER TECHNOLOGY. THE INFORMATION OFFERED IN THIS DOCUMENT ARE BELIEVED TO BE ACCURATE. WHILE ALL THE EFFORTS ARE MADE TO CREATE THE MOST ACCURATE RESULT; IT SHOULD BE CONSIDERED AS AN ESTIMATE. PLEASE CONTACT US DIRECTLY WITH ANY QUESTION REGARDING THIS PRODUCT AT: 1-877-776-7639 OR VISIT OUR WEBSITE FOR SAMPLES.

MERCEDEH ARBAB		36276
NAME	SIGNATURE	BCIN
MEMAR CONSULTANTS		36837
FIRM NAME	SIGNATURE	BCIN

PROJECT ADDRESS:

53 Lower Jarvis
 TORONTO, ON

DRAWING TITLE:


Gross Floor Area

NOTES:

1996 BOMA STANDARD
 Total Gross Floor Area
 4794.8 sq ft




MEMAR
 CONSULTANTS INC.
 This Product is Prepared by
 "Memar Consultants Inc."
 T: 1-877-776-7639
 T: 416-575-4448
 www.MemarConsultants.com

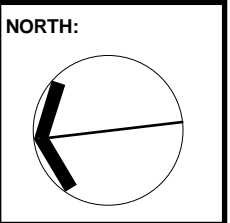

VERSION: 1.0
 DATE: 22/10/2009

A2

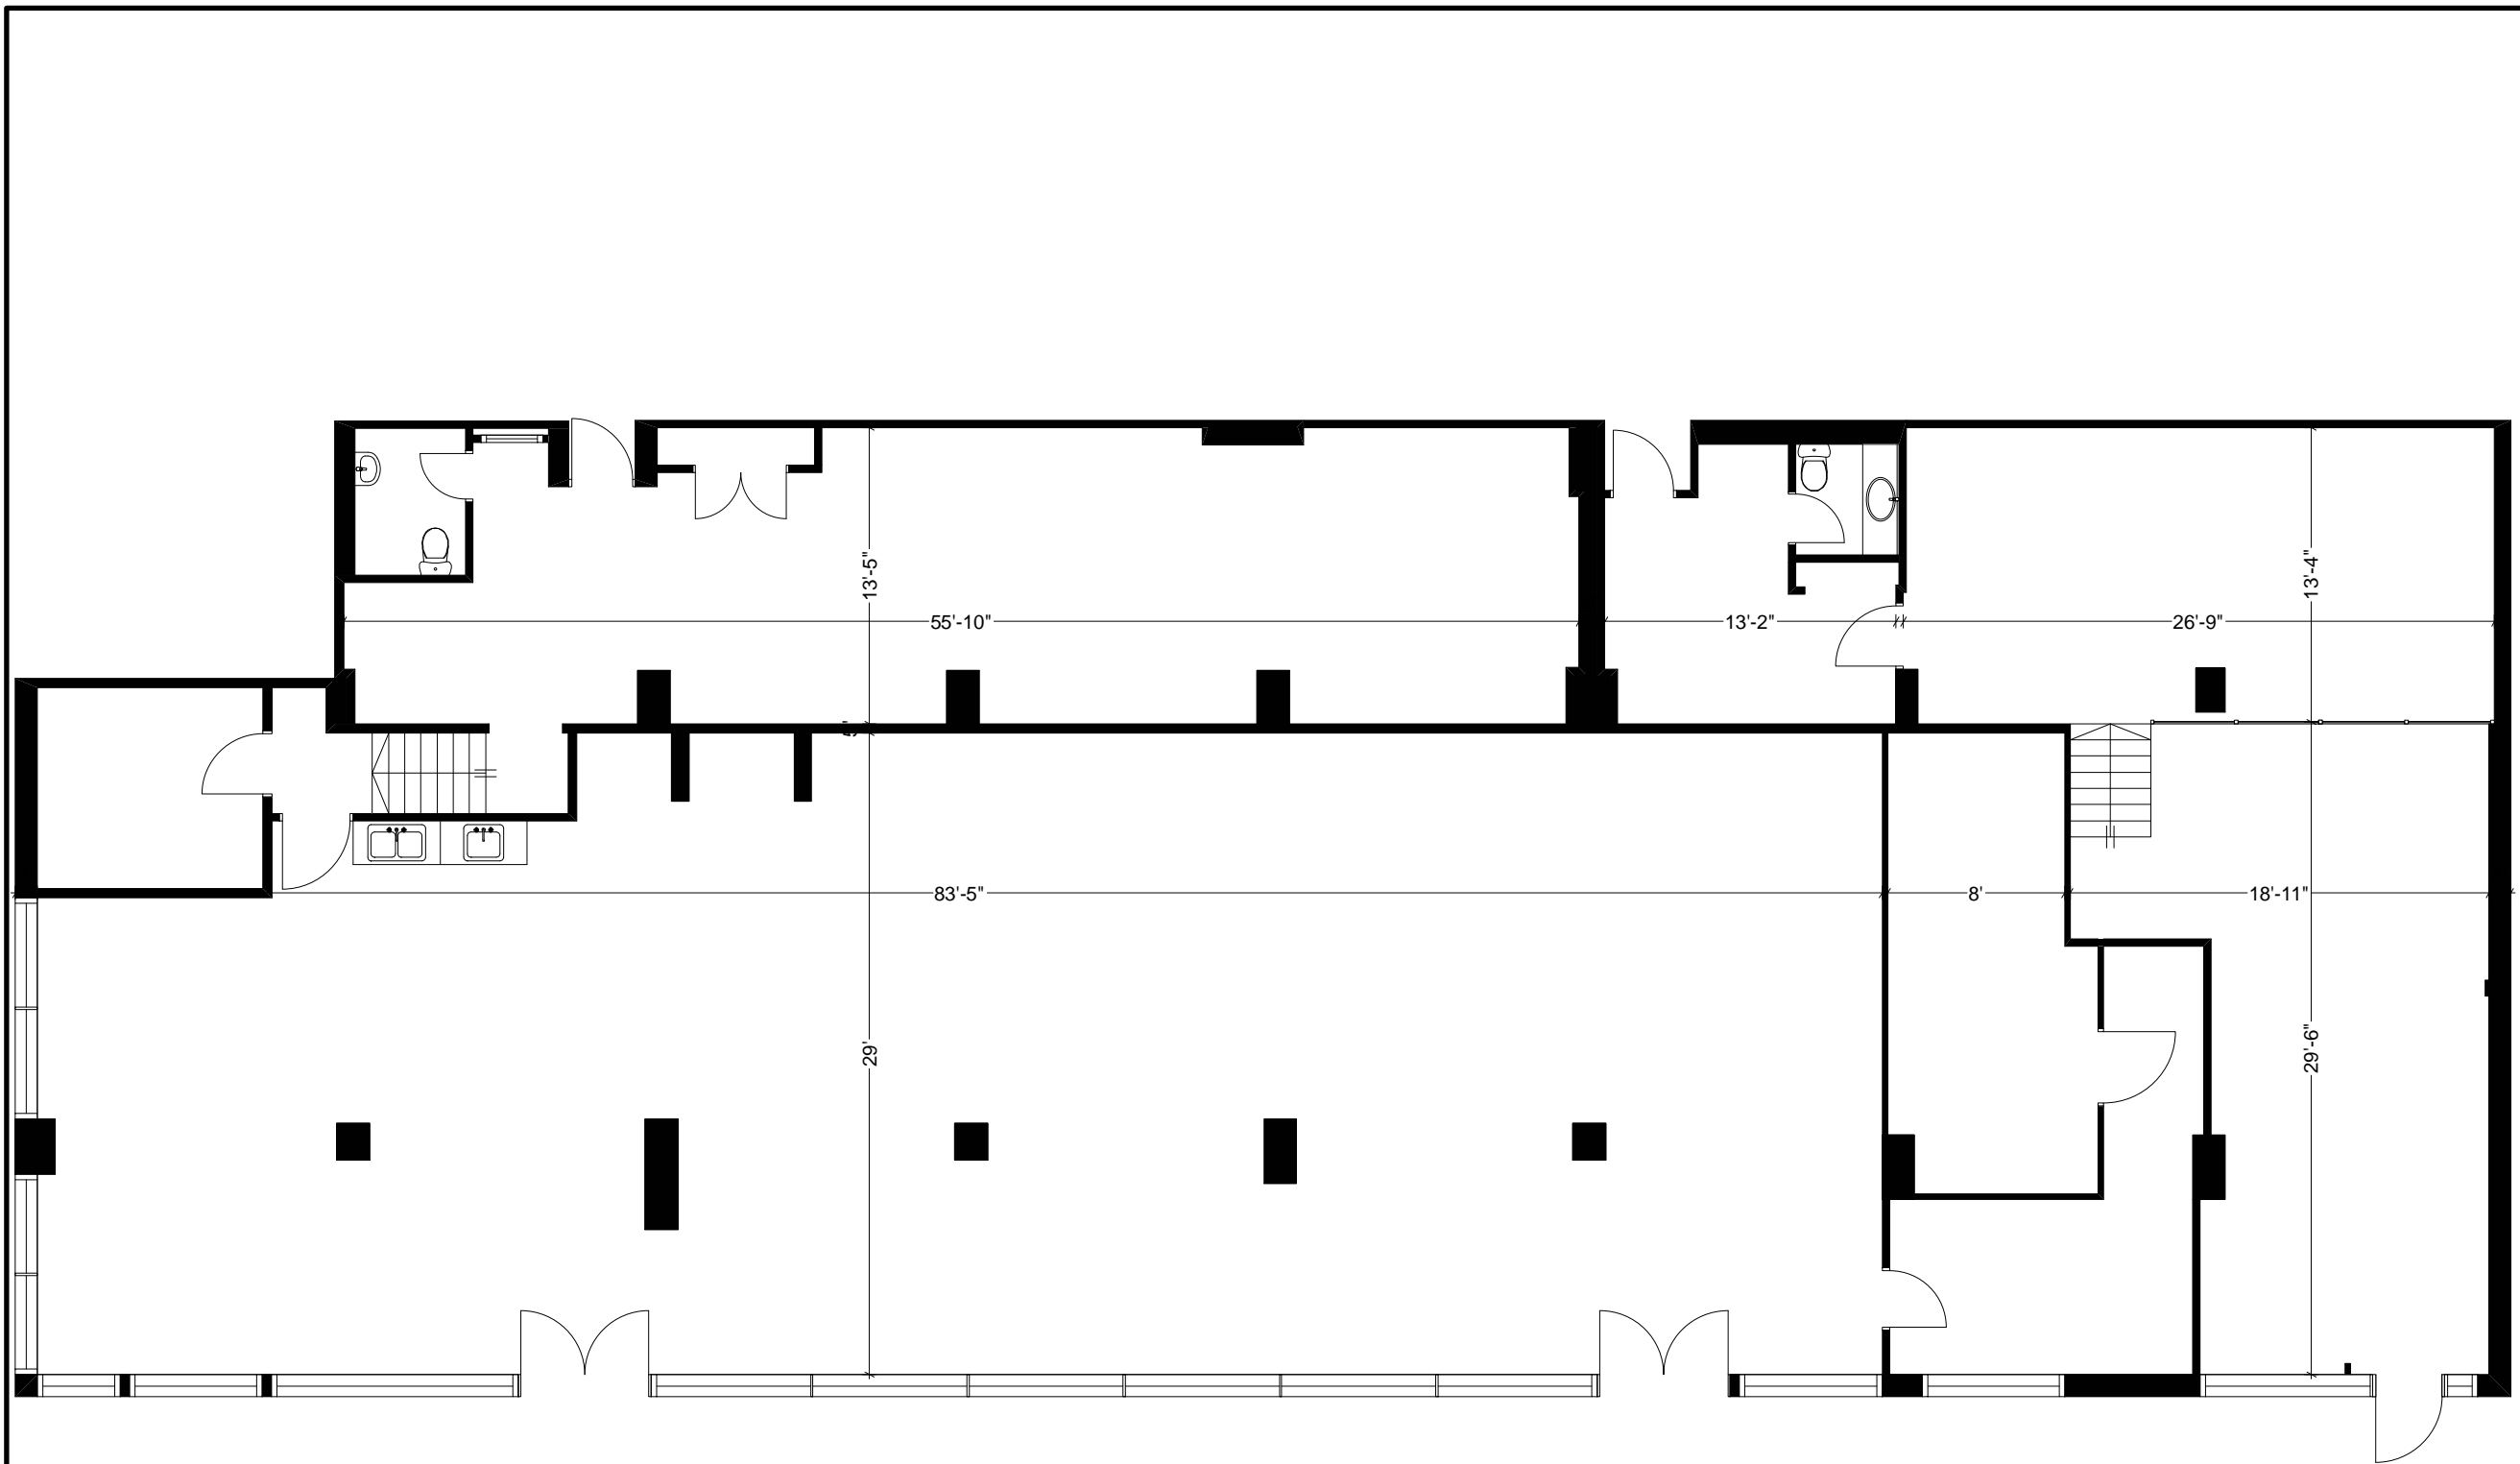

Toronto Community Housing Corporation

931 Yonge St., 3rd floor
 Toronto, ON, M2W 2H2
 Phone: 416-981-4173
 Fax : 416-981-4150



MEMAR CONSULTANTS INC. HAS CONDUCTED THE AS-BUILT MEASURING OF THIS BUILDING USING LASER TECHNOLOGY. THE INFORMATION AFFORDED IN THIS DOCUMENT ARE BELIEVED TO BE ACCURATE. WHILE ALL THE EFFORTS ARE MADE TO CREATE THE MOST ACCURATE RESULT; IT SHOULD BE CONSIDERED AS AN ESTIMATE. PLEASE CONTACT US DIRECTLY WITH ANY QUESTION REGARDING THIS PRODUCT AT: 1-877-776-7639 OR VISIT OUR WEBSITE FOR SAMPLES.

MERCEDEH ARBAB	<i>M. Arbab</i>	36276
NAME	SIGNATURE	BCIN
MEMAR CONSULTANTS	<i>Memar</i>	36837
FIRM NAME	SIGNATURE	BCIN

PROJECT ADDRESS:

53 Lower Jarvis
 TORONTO, ON

DRAWING TITLE:

Floor Plan


NOTES:

1996 BOMA STANDARD



This Product is Prepared by
 "Memar Consultants Inc."
 T: 1-877-776-7639
 T: 416-575-4448
 www.MemarConsultants.com

NORTH:

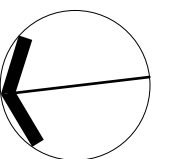

VERSION: 1.0

DATE: 22/10/2009

A2